Sheet 1 of 1

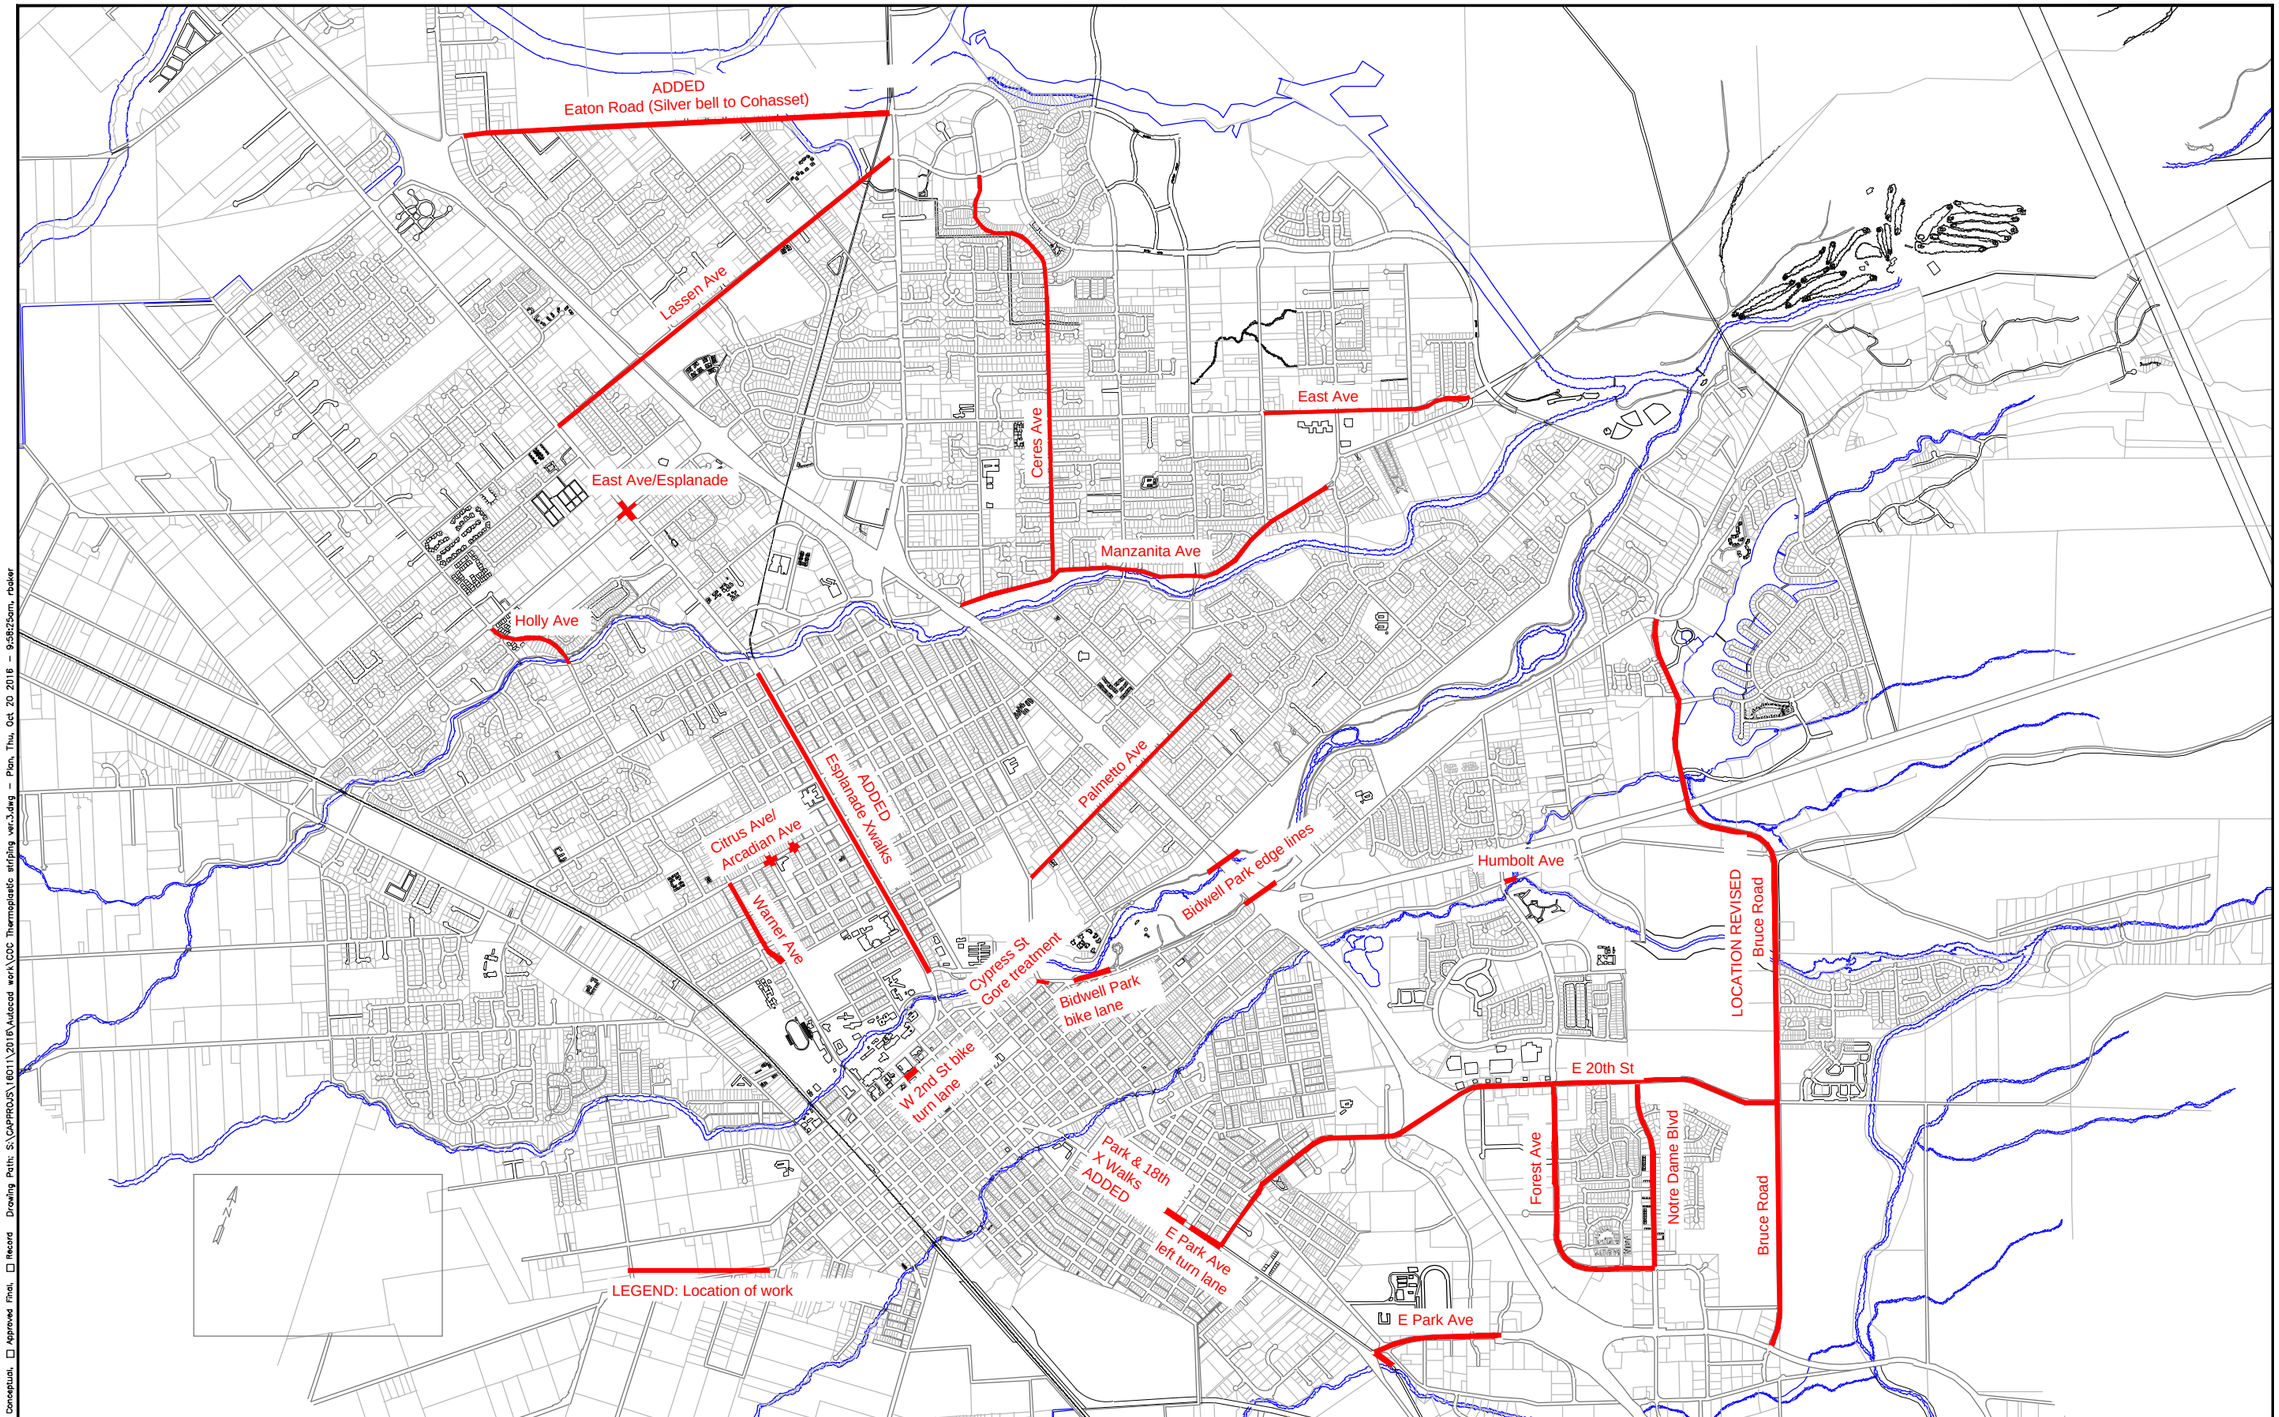

Title:

Drawing Number

Plan Status: ☐ Conceptual ☐ Approved Final ☐ Record Drawing Path: S:\CAPPROJS\16011\2016\Autocad work\COC Thermoplastic striping ver3.dwg - Plan, Thu, Oct 20 2016 - 9:58:25am, rpeker

Designed:	Approved:	Revision	Date	By
Drawn By:				
Checked:	Date:			

CITY OF CHICO
DEPARTMENT OF PUBLIC WORKS

Annual Thermoplastic Striping Project

Project Number: 16011

Scale: 1"= 1300'

Drawing Number

Sheet 1 of 1